

**STATEMENT OF AREA (SQ.M.)**

AREA OF SITE :- 16598.11 SQ.M (4.1 ACRE)  
 OPEN AREA :- 2170.85 SQ.M (13.07%)  
 ROAD AREA :- 5250.11 SQ.M (31.63%)  
 NO. OF PLOT :- 108 NO.  
 AREA OF EACH PLOT :- 83.62 SQ M  
 AREA OF SHOPS :- 240.67 SQM  
 NO. OF SHOPS :- 10 NO.S

UTILITY SHOP NO. 3200 x 4500



SHOP 176000  
 3.0 M WIDE CORRIDOR

**PRIVATE SECTOR**

**NOTE:- APPROVED PORTION 'A-B-C-D-E-F-G' SHOWN IN RED COLOUR FOR SCHEME.**

2464 31.8.2005  

**LIG HOUSING SCHEME FOR DEENDAYAL AWAS YOJNA AT BHILAI-3.**

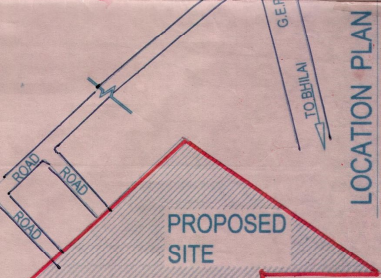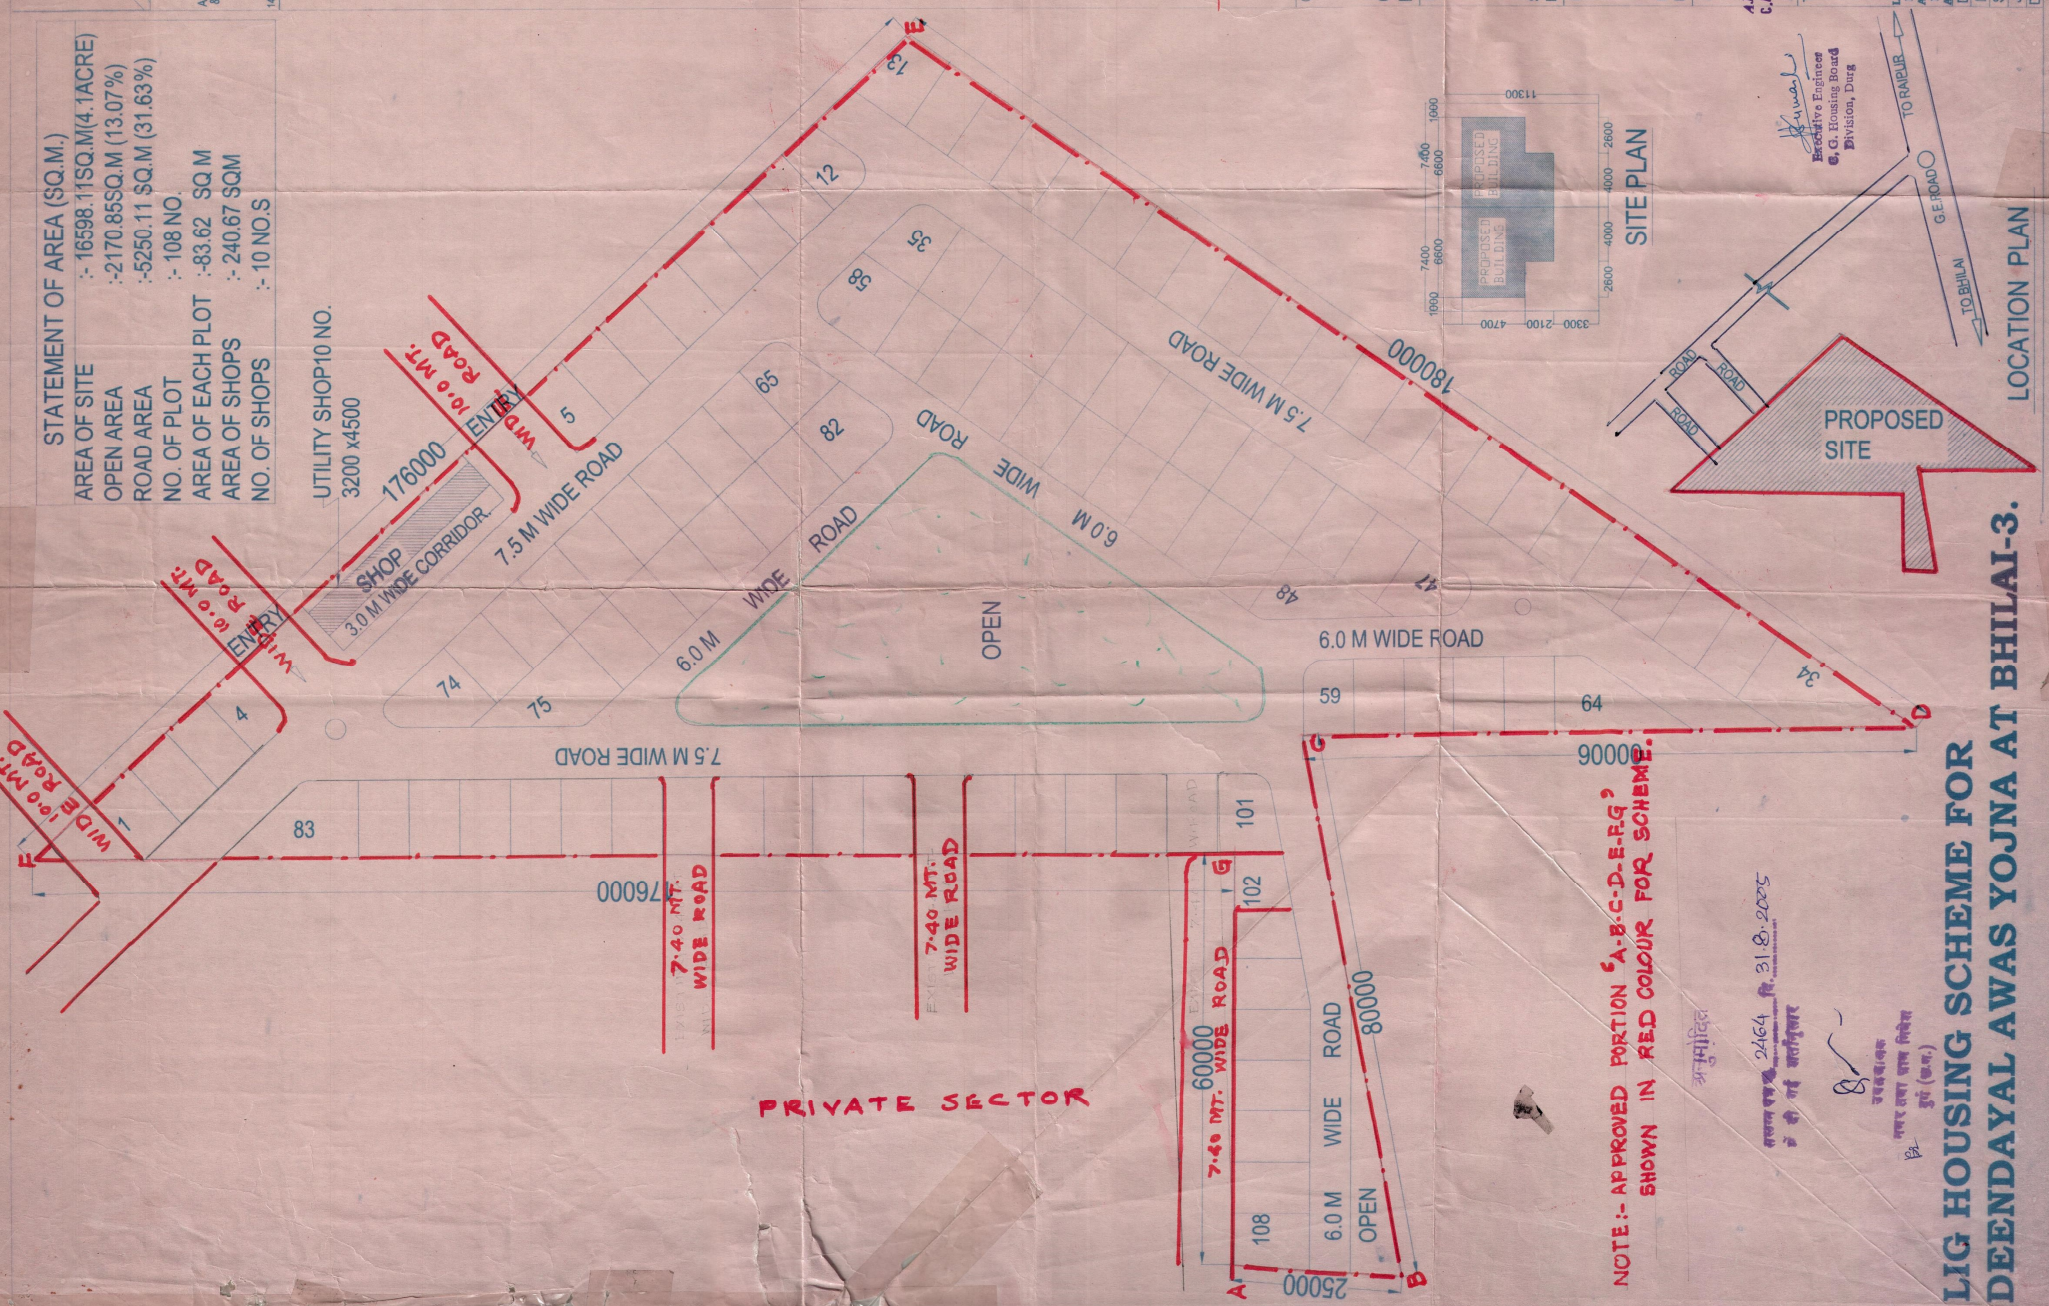

A.V.B ASSOCIATES ARCHITECTS, ENGINEER & INTERIOR DESIGNER.  
 145, MALVIYA NAGAR BHOPAL

CLIENT: CHHATTISGARH HOUSING BOARD FOR CGHB  
 SAMEER CHAUDHARY DY. HOUSING COM. FOR CGHB  
 HARSH KUMAR JOSHI EXECUTIVE ENGINEER ARCHITECT  
 AJAY DOKRAR ARCHITECT C.A. Registration CA 8114236  
 AMY BORKAR.  
 TITLE: LIG HOUSING SCHEME FOR DEENDAYAL AWAS YOJNA REASA- NO.389/2, 389/4 BHILAI-3  
 DEALT: SHENAYLA  
 DATE: 07.02.2005  
 SCALE: 1:500  
 JOB NO. 2005/19  
 DRG NO. 101